


AB BT 0089133 -344  
HUSKY 12-28-064-04W4  
HUSKY TUCKER LAKE 12-28 BITUMEN MWB  
IN-SITU OIL SANDS BATTERY  
LICENSEE: HUSKY OIL OPERATIONS LTD  
OPERATOR: HUSKY OIL OPERATIONS LTD

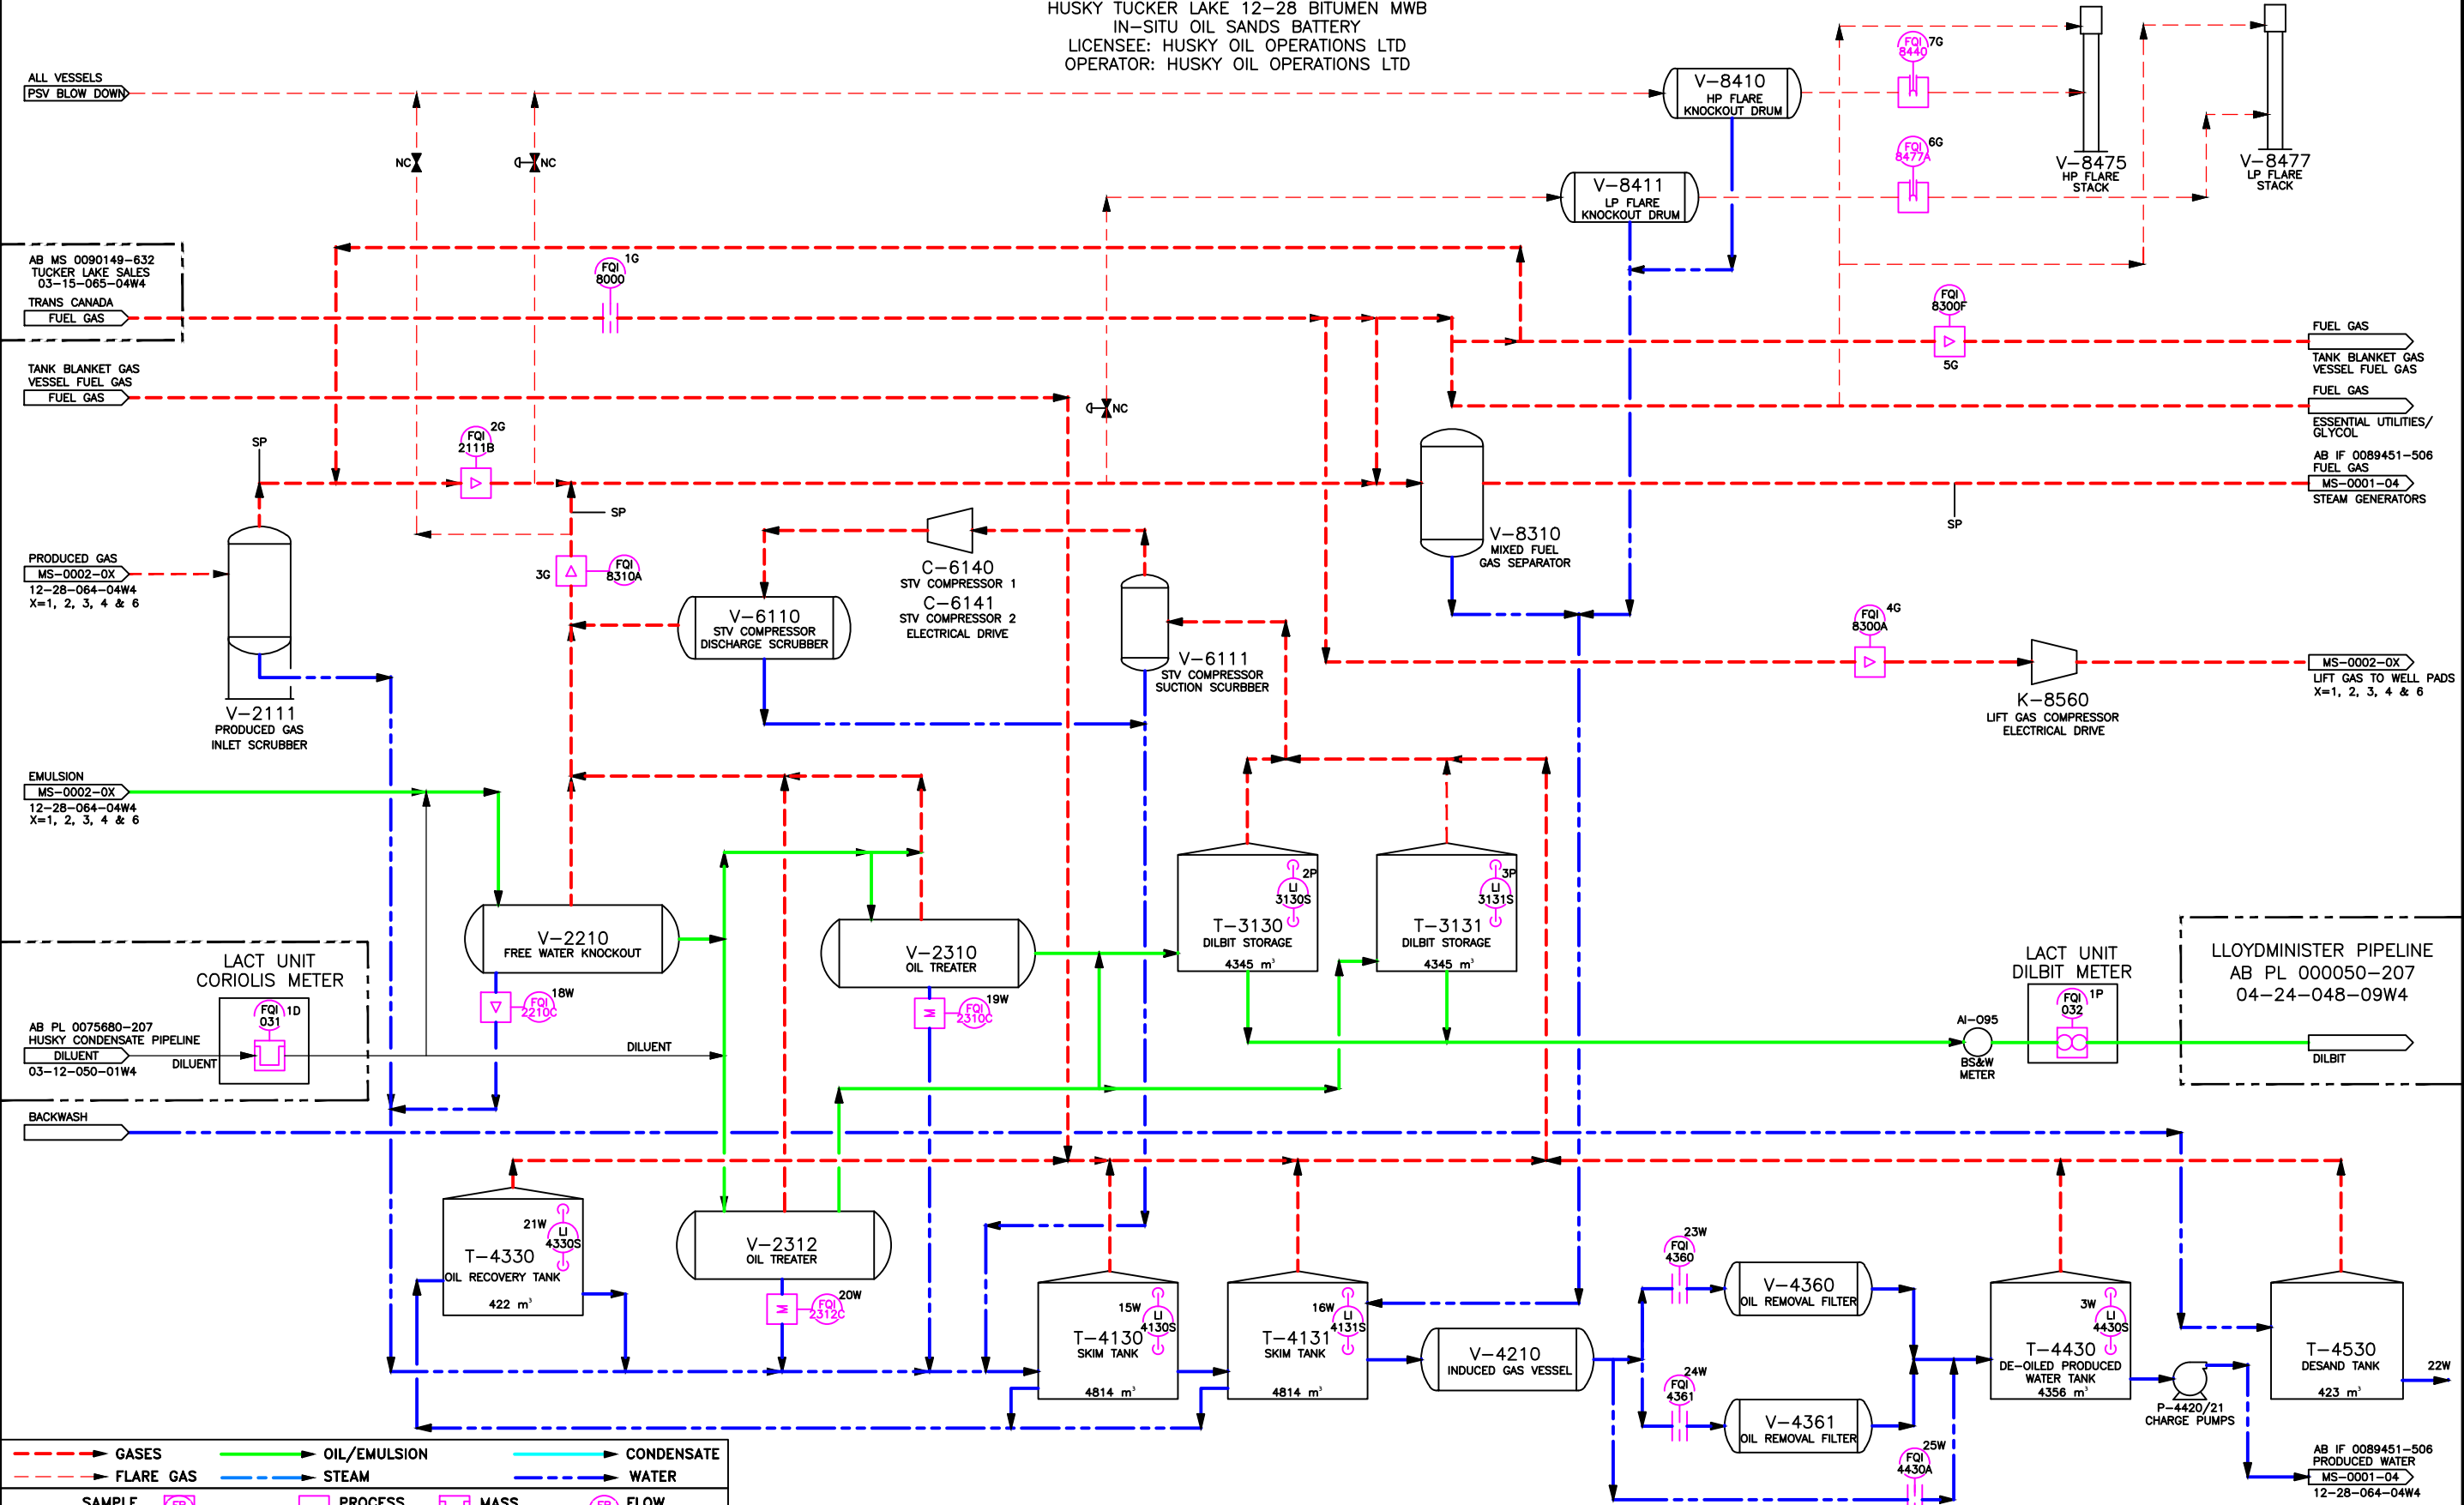

SP

PT

PROVER TAPS

NOA

NOA

NET OIL ANALYZER

S

S

STRAINER

P

P

PROBE STYLE OPTICAL

FR

FR

DCS RTU PLC

PM

PM

PROCESS METER

ORF

ORF

ORIFICE METER

M

M

MAGNETIC FLOW METER

TEMP

TEMP

TEMPORARY METER

FR

FR

FLOW RECORDER

FQI

FQI

FLOW TOTALIZER

UL

UL

ULTRASONIC METER

POS

POS

POSITIVE DISPLACEMENT METER

V-C

V-C

V-CONE (WAFER CONE) METER

REF DWG NO	REFERENCE DRAWING DESCRIPTION	NO	REVISION HISTORY	REV AUTHOR	REV DATE	ISSUED FOR	NO	CURRENT REVISION	ISSUED FOR	AS BUILT
MS-0000-01	AREA OVERVIEW	1	CREATED FROM MARK UPS FROM ALLYSON HADLAND	SK	2016/02/24	AS BUILT	4	UPDATED FROM MARK UPS FROM ELSIE GUERRA	DOC DATE	2017/02/28
MS-0001-01 & 02	FACILITY DRAWING	2	NO UPDATES FOR THIS REVISION FROM ALLYSON HADLAND	PC	2016/08/12	AS BUILT			DOC AUTHOR	SK
MS-0002-01 TO 05	GATHERING SYSTEM	3	UPDATED PER MARK UPS FROM ALLYSON HADLAND	SK	2017/01/19	AS BUILT			SCALE	NTS
MS-0007-01	STEAM INJECTION SYSTEM	4							ALTERNATE IDENTIFIER	
MS-0010-01	LACT UNIT	5							SURFACE L&D	12-28-064-04W4
		6							DOCUMENT IDENTIFIER	MS-0001-03
		7								

**Husky Oil Operations Limited**

TUCKER CENTRAL PLANT 12-28-064-04W4  
FACILITY DRAWING  
MEASUREMENT SCHEMATIC

CAD DRAWING: DO NOT CHANGE MANUALLY