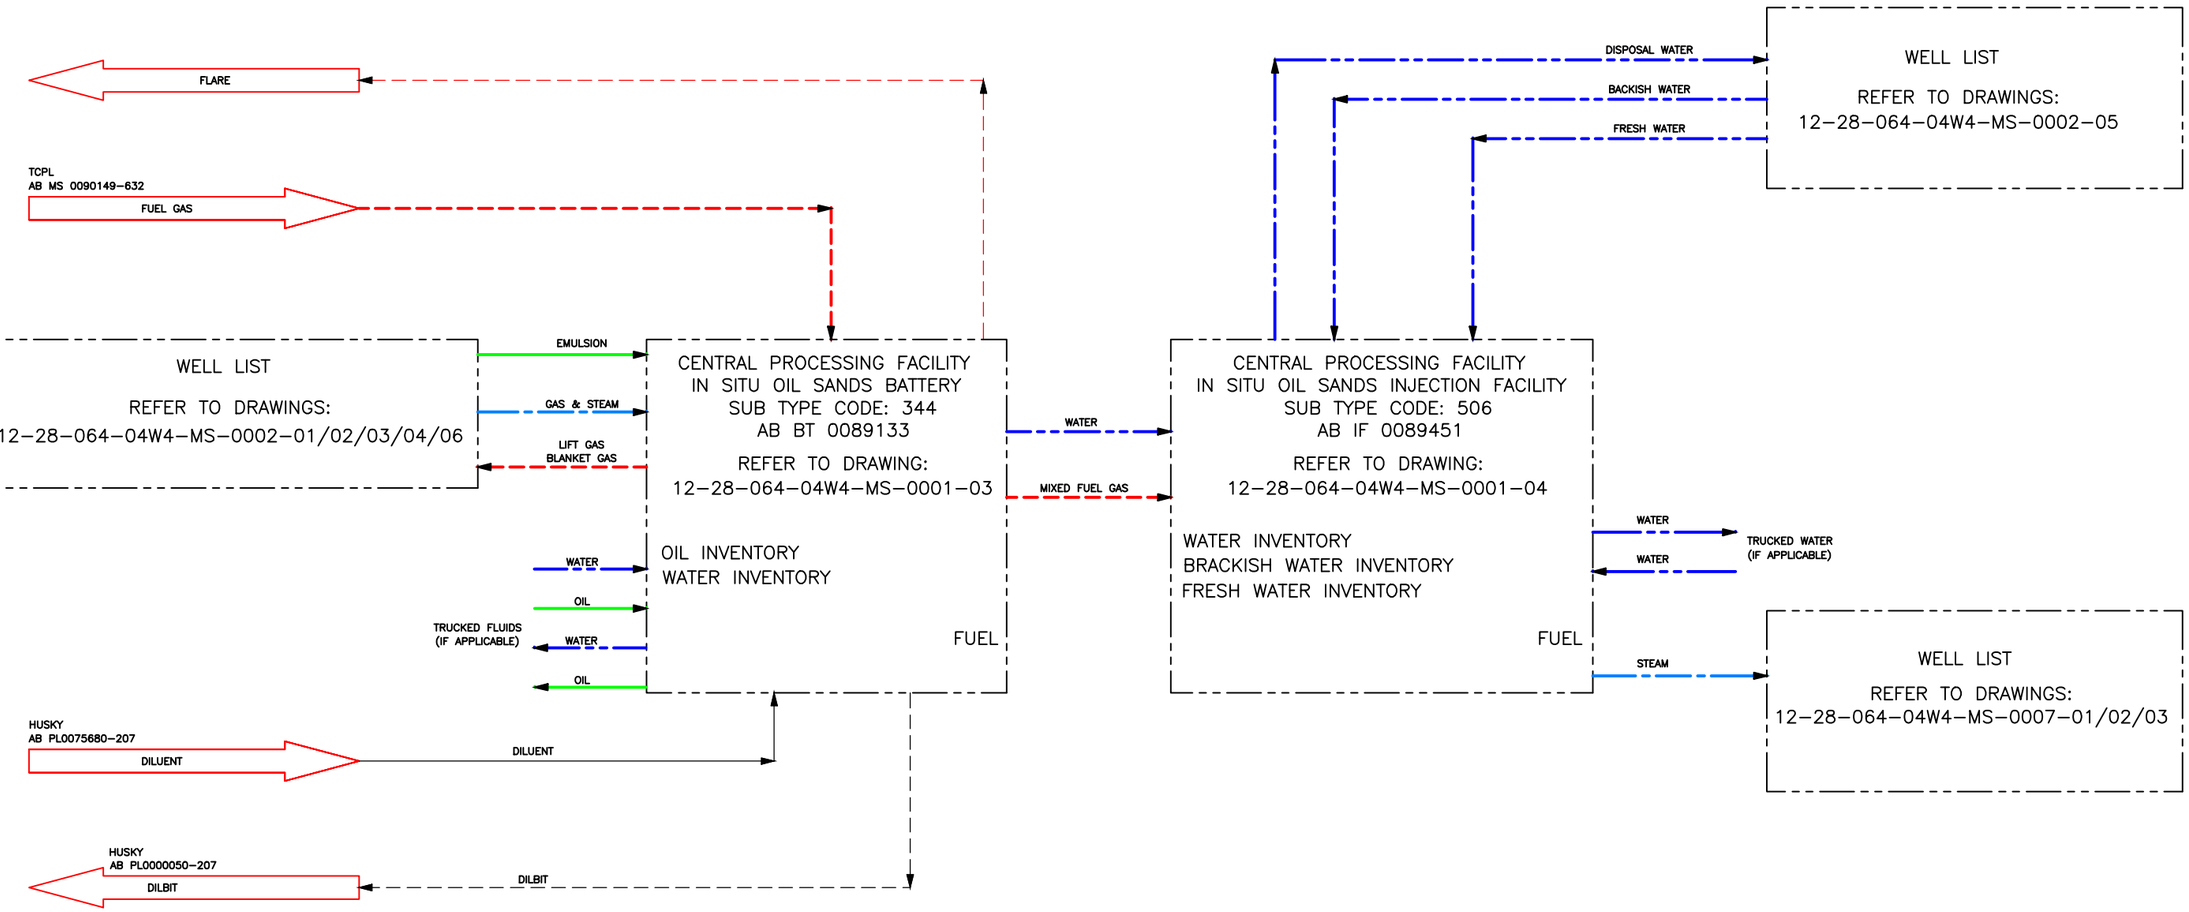

GASES
FLARE GAS
OIL/EMULSION
STEAM
DILUENT
DILBIT
WATER

SAMPLE POINT (SP)
PROVER TAPS (PT)
FLOW NOZZLE
STRAINER (S)
PROBE STYLE OPTICAL (P)
DCS (FR)
RTU PLC
NET OIL ANALYZER (NOA)
ROTAMETER
TEMPORARY METER (GOR)
PROCESS METER (PM)
ORIFICE METER
TURBINE METER
MAGNETIC FLOW METER (M)
VORTEX METER
MASS METER
THERMAL MASS METER
ULTRASONIC METER
POSITIVE DISPLACEMENT METER
V-CONE (WAFER CONE) METER
FLOW RECORDER (FR)
FLOW TOTALIZER (FQI)

REF DWG NO	REFERENCE DRAWING DESCRIPTION
MS-0001-01 & 02	FACILITY DRAWING
MS-0002-01 TO 05	GATHERING SYSTEM
MS-0007-01	STEAM INJECTION SYSTEM
MS-0010-01	LACT UNIT

NO	REVISION HISTORY	REV AUTHOR	REV DATE	ISSUED FOR
1	UPDATED PER FIELD SUPPLIED MARK UPS	EPC_CALTECH	2006/07/26	AS BUILT
2	UPDATED PER FIELD SUPPLIED MARK UPS	BRM	2009/03/19	AS BUILT
3	NO UPDATES FOR THIS REVISION FROM ALLYSON HADLAND	SK	2014/08/20	AS BUILT
4	UPDATED FROM MARK UPS SUPPLIED BY ALLYSON HADLAND	BRM	2015/02/24	AS BUILT
5	NO UPDATES FOR THIS REVISION FROM ALLYSON HADLAND	BRM	2015/10/29	AS BUILT
6	UPDATED FROM MARK UPS FROM ALLYSON HADLAND	SK	2016/02/24	AS BUILT
7	NO UPDATES FOR THIS REVISION FROM ALLYSON HADLAND	PC	2016/08/12	AS BUILT

NO	CURRENT REVISION
8	UPDATED FROM MARK UPS FROM ELSIE GUERRA

Husky Oil Operations Limited

TUCKER CENTRAL PLANT 12-28-064-04W4

AREA OVERVIEW
MEASUREMENT SCHEMATIC

ISSUED FOR	AS BUILT
DOC DATE	2017/02/28
DOC AUTHOR	SK
SCALE	NTS
ALTERNATE IDENTIFIER	
SURFACE LSD	12-28-064-04W4
DOCUMENT IDENTIFIER	MS-0000-01

CAD DRAWING: DO NOT CHANGE MANUALLY